

5/17

DART AEROSPACE LTD		Work Order:	22923
Description: 206 L/L-1/L-3/L-4 HighGear Web		Part Number:	D2654-7
Drawing: D2654 Rev. D/EI ^{04.08.17 kg} ^{04.08.17 qf}		Qty:	2 u

Step	Location	Procedure	By	Date	Qty
1	EXPEDITING	Issue Work Order	kg	05.04.06	②
2	METAL	Pick: Qty Part Number Description Batch 1 D2600-7 Web B21960	DP	05/6/6	2
3	METAL	Cut D2600-7 to length as per Dwg D2654 (116.00") 04.07.07 ^{04.07.07}	DP	05/6/6	2
4	METAL	Drill pilot holes in web using drill jig DT 8018-7 as per Dwg D2654	DP	05/6/6	2
5	METAL	Using the uni-bit, open holes to finish size as per Dwg D2654	DP	05/6/6	2
6	METAL	Deburr holes and ends	DP	05/6/6	2
7	METAL	Acid Etch and Alodine as per QSI 005 4.1	FF	05/6/07	2
8	QC	Inspect Level 5	DP	05/6/07	2
9	METAL	Identify and stock	DP	05/6/19	2
10	EXPEDITING	Close Work Order ^{33.48} Cost/part: ^{33.48}	kg	05.06.15	2

Rev	Date	Change	Revised By	Approved
A	97.07.30	New Issue	JB	
B	97.08.28	Change part No. Step 1 & 2	KS	
C	98.09.14	Re-format, drawing rev.	CS	
D	99.02.04	Fixed typo, Changed procedure	DM	(S)

MANUFACTURER RELEASE CERTIFICATION

D.O.T Approval 9- 89

The aeronautical product described hereon conforms to approved type design data and is in a condition for safe operation.

RELEASED
DM 99.02.19

W/O:		WORK ORDER CHANGES						
DATE	STEP	PROCEDURE CHANGE		By	Date	Qty	Approval Mfg / Design Mgr	Approval QC Inspector

NCR:		WORK ORDER NON-CONFORMANCE (NCR)						
DATE	STEP	Description of NC Section A	Corrective Action			Verification Section C	Approval Design Mgr	Approval QC Inspector
			Initial Design Mgr	Action Description Design Mgr	Sign & Date			

Part No: _____ PAR #: _____ Fault Category: _____

NOTE: Date & initial all entries




NCR: Yes No DQA: _____ Date: _____

QA: N/C Closed: _____ Date: _____



DESIGN <i>CP</i>	DRAWN BY <i>CP</i>	DART AEROSPACE USA, INC. PORT HADLOCK, WA	
CHECKED <i>#</i>	APPROVED <i>#</i>	DRAWING NO. D2654	REV. E SHEET 1 OF 2
DATE 04.05.26		TITLE WEB	SCALE 1:20
A	97.03.25	NEW ISSUE	
B	97.06.26	ALTER HOLE PATRN., 0.500 WAS 0.438	
C	97.10.29	CHANGED HOLE PATTERN	
D	98.01.15	GHW HOLES CHANGED TO $\phi 0.63$	
E	04.05.26	CHANGE LENGTHS, REFORMAT	
E1	<i>CP</i> 04.08.04	PER TOOLING; 80.8 WAS 80.5	

RELEASED
04.06.22

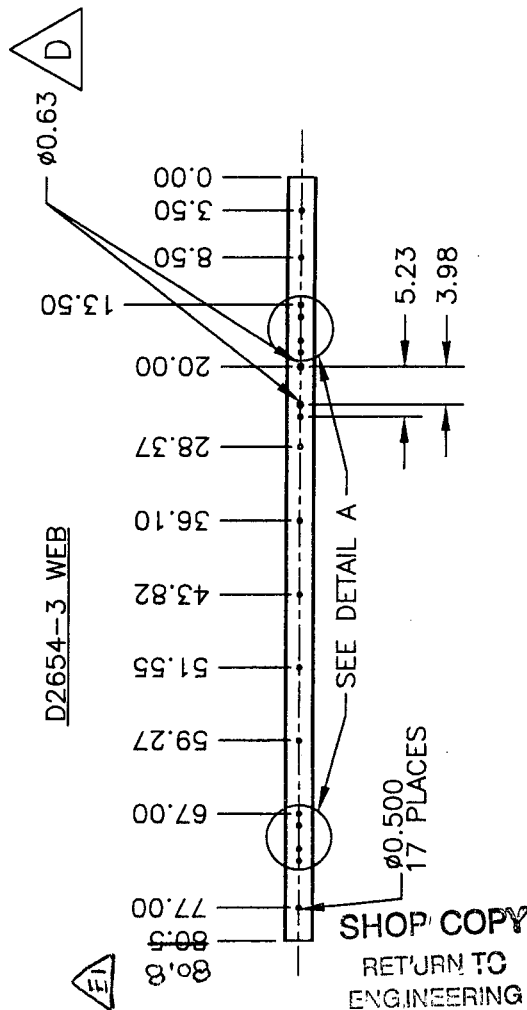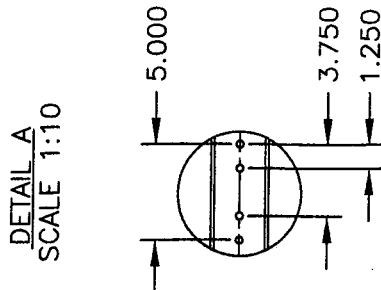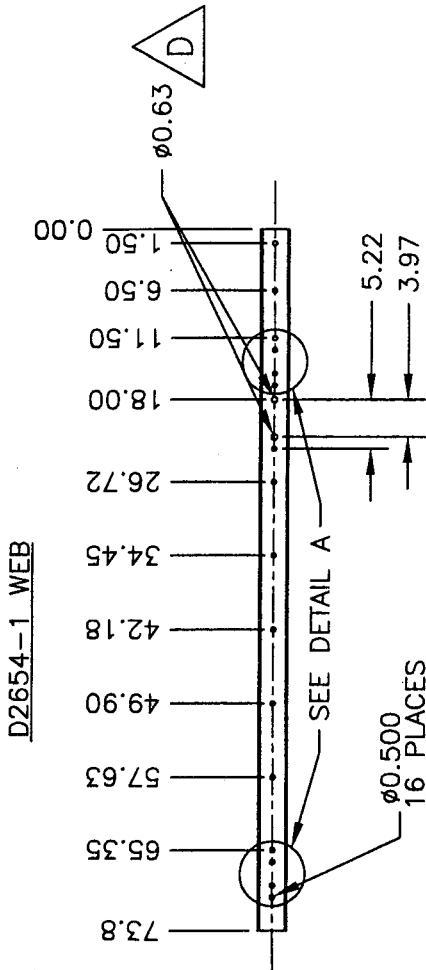


UNCONTROLLED COPY
SUBJECT TO AMENDMENT
WITHOUT NOTICE

WORK ORDER
22923

MAKE FROM D2600-5-108 EXTRUSION
FINISH: CHEMICAL CONVERSION COAT PER DART QSI 005 4.1
TOLERANCES ARE PER DART QSI 018 UNLESS OTHERWISE NOTED

Copyright © 1997 by DART AEROSPACE USA, INC.

THIS DOCUMENT IS PRIVATE AND CONFIDENTIAL AND IS SUPPLIED ON THE EXPRESS CONDITION THAT IT IS NOT TO BE USED FOR ANY PURPOSE OR COPIED OR COMMUNICATED TO ANY OTHER PERSON WITHOUT WRITTEN PERMISSION FROM DART AEROSPACE USA, INC.

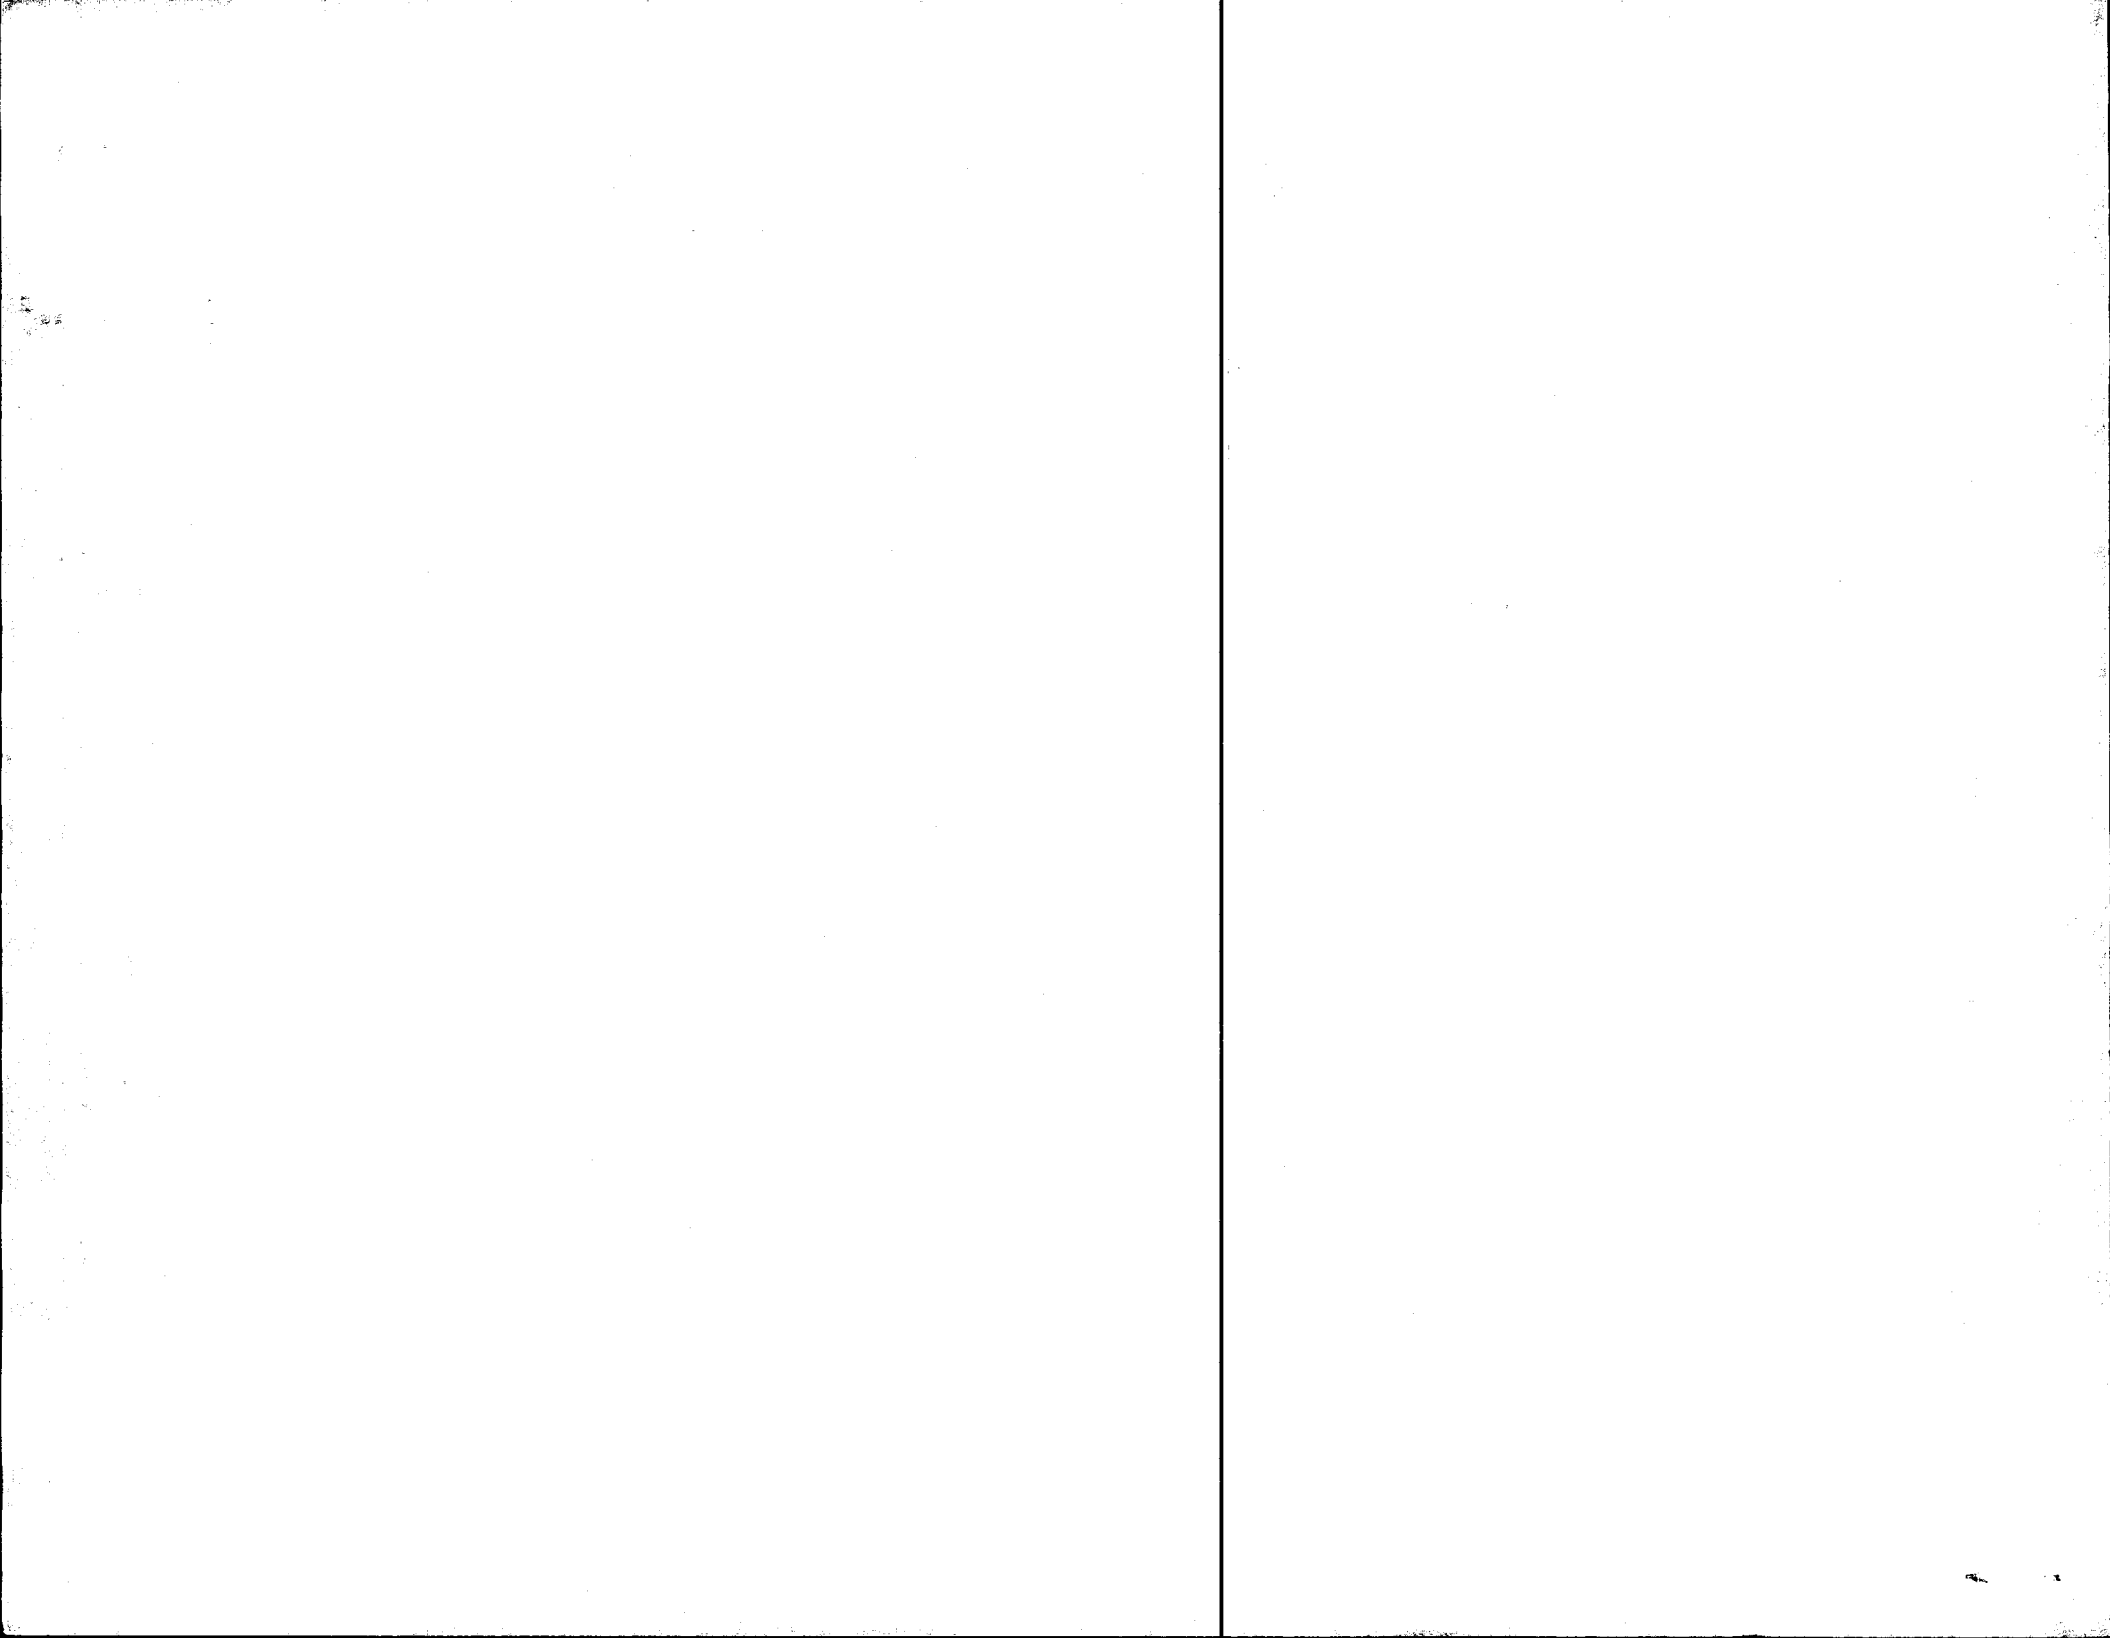





DESIGN CP	DRAWN BY CP	DART AEROSPACE USA, INC. PORT HADLOCK, WA	
CHECKED [Signature]	APPROVED [Signature]	DRAWING NO. D2654	REV. E SHEET 2 OF 2
DATE 04.05.26	TITLE WEB	SCALE 1:20	

RELEASED
04.06.22


DETAIL A
SCALE 1:10

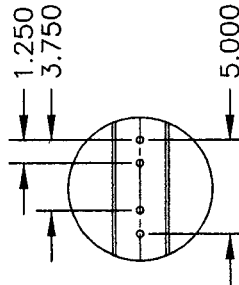

D2654-5 WEB

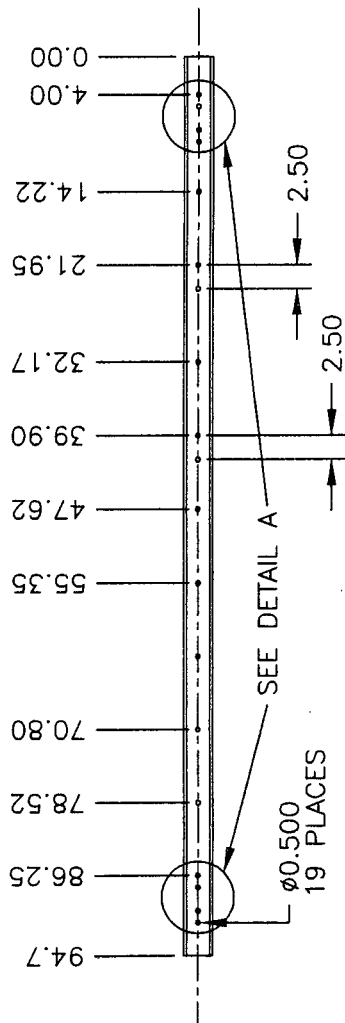

D2654-7 WEB

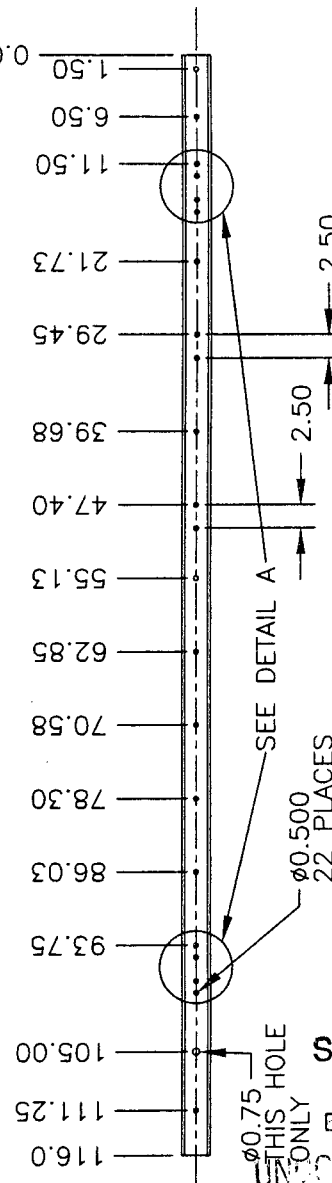

MAKE FROM D2600-7-125 EXTRUSION
FINISH: CHEMICAL CONVERSION COAT PER DART QSI 005 4.1
TOLERANCES ARE PER DART QSI 018 UNLESS OTHERWISE NOTED

THIS HOLE
ONLY
UNCONTROLLED COPY
SUBJECT TO AMENDMENT
WITHOUT NOTICE

WORK ORDER
NO. 22923

Copyright © 1997 by DART AEROSPACE USA, INC.

THIS DOCUMENT IS PRIVATE AND CONFIDENTIAL AND IS SUPPLIED ON THE EXPRESS CONDITION THAT IT IS NOT TO BE USED FOR ANY PURPOSE OR COPIED OR COMMUNICATED TO ANY OTHER PERSON WITHOUT WRITTEN PERMISSION FROM DART AEROSPACE USA, INC.

Job Costing Report

Dart Aerospace Ltd.
Hawkesbury

Apr 04, 2005
12:27 pm

Work Order No : 0022923
Project Name : D2654-7
Project For : WK517
Work Order Type : Main
Main WO Number :
House Part Number : D2654-7
Description : 206 I Beam (Web)
Manufactured : Yes
Amount Req'd : 12
Amount Done : 0
Start Date : 04-04-05
Est Finish Date : 04-22-05
Act Finish Date :
Drawings Req'd : No
Ok for Approval :
Approval Rec'd :

Department Code:
Burden Flags : NNNNNNNN
WO Status : Open
Invoice State : Not Invoiced
Invoice Date :
Invoice Number :
Invoice Amount : 0.00
Order Entry No :
OE Value : 0.00
Est Mark Up : 0.000%
Actual Mark Up : 0.000%
\$0 Posted to Finished Goods

	Estimated	Actual	Var. %	Posted	To Post
Material Cost :	0.00	0.00	0.00	0.00	0.00
Engineering Hours :	0.00	0.00	0.00		
Engineering Cost :	0.00	0.00	0.00	0.00	0.00
Production Hours :	0.00	0.00	0.00		
Production Cost :	0.00	0.00	0.00	0.00	0.00
Packaging Hours :	0.00	0.00	0.00		
Packaging Cost :	0.00	0.00	0.00	0.00	0.00
OverHead Hours :	0.00	0.00	0.00		
OverHead Cost :	0.00	0.00	0.00	0.00	0.00
CNC Hours :	0.00	0.00	0.00		
CNC :	0.00	0.00	0.00	0.00	0.00
Misc. Hours :	0.00	0.00	0.00		
Misc. :	0.00	0.00	0.00	0.00	0.00
Burden :	0.00	0.00	0.00		
Total Cost :	0.00	0.00	0.00		
Mark up :	0.000	0.000			
Selling Cost :	0.00	0.00			

	Estimated	Actual
Labour Hrs/Amount Done :	0.00	0.00
Profits/(Loss) :	0.00	0.00